IN THE CITY OF RIVERSIDE CU - 011 - 967STREET IMPROVEMENT PLAN

50'

43'

(2.2~2.4%)

EX. MED. CURB

44'

EX. PAVEMENT

(3.9~4.9%)

SAWCUT LINE

EX. TC

 $-1.22 \sim -1.44$

R/W

REMOVE & REPLACE EX. PAVING 3 1/2" A.C. OVER 4" A.B. PER S.R. 415 R=67 (OR 51/2" A.C.

OVER COMPACTED NATIVE)

6.5'

EX. TC

 $-0.80 \sim -1.10$

TI = 8.5 N.T.S

47'

VAN BUREN BLVD.

0.00


CALIFORNIA AVENUE

PUBLIC UTILITIES DEPARTMENT—WATER

CITY OF RIVERSIDE

LEVEL LINE

STA, 21+28,51 TO STA, 21+94,54

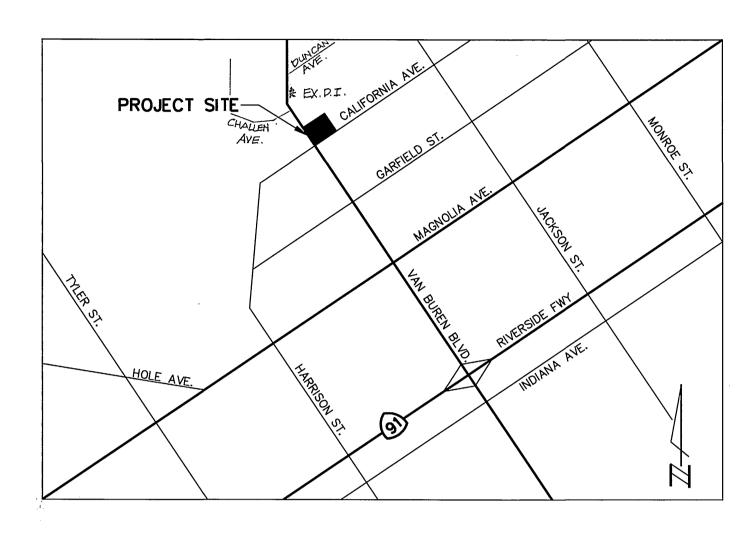

VICINITY MAP

CONSTRUCTION NOTES

- (1) CONSTRUCT 4 1/2" A.C. OVER 5" CKUSHED AGG. BASE. PER S.R. 415. R=67 (OR 71/2"A.C. OVER COMPACTED NATIVE)
- $\langle \overline{2} \rangle$ CONSTRUCT 6" CURB & GUTTER PER CITY STD. 200 TYPE I (3) CONSTRUCT WHEELCHAIR RAMP PER CITY STD. 304.
- CONSTRUCT CURB SIDEWALK PER CITY STD. 325.
- CONSTRUCT DRIVEWAY APPROACH PER CITY STD. 302 TYPE CURB-11
- SAWCUT PAVING 1' FROM EXIST. GUTTER REMOVE EXIST. C & G.
- REMOVE EXIST. SIDEWALK
- CONSTRUCT CURB OUTLET PER MODIFIED CITY STD. 410 & DETAIL A THIS SHT. RELOCATE EXIST. TRAFFIC SIGNAL & PULL BOX PER TRAFFIC SIGNAL PLAN X-331A.
- PROTECT IN PLACE.
- RELOCATE EXIST. UTILITY POLE AND DOWN GUY (BY CITY FORCES OR PHONE CO. AT DEVELOPER'S EXPENCE)
- RELOCATE EXIST. AIR RELEASE VALVE (BY CITY FORCES)
- RELOCATE EXIST. SIGNS
- EXIST. WATER SERVICE LINE TO BE CUT AND PLUGGED AT MAIN (BY CITY FORCES)
- RELOCATE EXIST. PALM TREE
- * INSTALL FOSSIL FILTER PER KRISTAR ENTERPRISES PRODUCTS OR EQUAL AT EXIST. CMP DROP INLET 1400' + NORTH OF THE PROJECT SITE, LOCATION AS SHOWN ON VICINITY MAP. FOR PRODUCT INFORMATION, CALL 1-800-950-3002, CHUCK McKINLEY

LEGEND:



CONSTRUCT A.C. OVER AGG. BASE.



CONCRETE

PROP. ST. TREE LOCATION

CITY OF RIVERSIDE PUBLIC UTILITIES DEPARTMENT-ELECTRIC

TOLL FREE

– 2600

OVERHEAD & UNDERGROUND APPROVED BY

Underground Service Alert

TWO WORKING DAYS BEFORE YOU DIG

5-14-97 DATE 'APPROVED BY

THE GAS COMPANY

PRIVATE ENGINEERING NOTE

CONSTRUCTION CONTRACTOR AGREES THAT IN ACCORDANCE WITH GENERALLY ACCEPTED CONSTRUCTION PRACTICES, CONSTRUCTION CONTRACTOR WILL BE REQUIRED TO ASSUME SOLE AND COMPLETE RESPONSIBILITY FOR JOB SITE CONDITIONS DURING THE COURSE OF CONSTRUCTION OF THE PROJECT, INCLUDING SAFETY OF ALL PERSONS AND PROPERTY; THAT THIS REQUIREMENT SHALL BE MADE TO APPLY CONTINUOUSLY AND NOT BE LIMITED TO NORMAL WORKING HOURS, AND CONSTRUCTION CONTRACTOR FURTHER AGREES TO DEFEND, INDEMNIFY AND HOLD DESIGN PROFESSIONAL HARMLESS FROM ANY AND ALL LIABILITY, REAL OR ALLEGED, IN CONNECTION WITH THE PERFORMANCE OF WORK ON THIS PROJECT, EXCEPTING LIABILITY ARISING FROM THE SOLE NEGLIGENCE OF DESIGN PROFESSIONAL.

6-17-97 APPROVED BY DATE PREPARED UNDER THE DIRECTION OF

HUA LIN McCAFFREY

No. 49405

Exp. 9-30-00

RIVERSIDE TRANSIT AUTHORITY

DATE //Ŕ.C.E. NO,/ 49405 EXPIRATION DATE: 9-30-00 DATE: 14-24

APPROVED BY

STA. 25+34.33 TO STA. 26+39.35

CITY OF RIV. BUSINESS TAX ACCT. NO. 69372 EXP. DATE 04-07-98 CITY OF RIVERSIDE BANCHMARK F3-D, PK NAIL IN NORTHERLY

CURB RETURN OF VAN BUREN BLVD. AND CALIFORNIA AVE.

CANTY ENGINEERING GROUP, INC. 3120 CHICAGO AVENUE, SUITE 180, P.O. BOX 52050, RIVERSIDE, CA 92517 FAX (909) 683 - 5301 TEL (909) 683 - 5234

STREET TREE PLANTING NOTES

- 1. All related work shall conform to the City of Riverside Park and Recreation
- services and sewer lateral have been marked, but prior to digging plant pits, all final street tree locations are to be spotted in the field by the Street Tree Inspector;
- b. while digging plant pits and planting/relocating trees;
- completed, for start of maintenance; released until after receipt of written notification from the City that
- 3. All STREET TREES ARE TO BE PLANTED PRIOR TO OCCUPANCY.

assuming maintenance responsibilities;

- 4. The developer shall be responsible to acceptably maintain all plantings for a minimum period of one (1) year.

 Street Name	Botanical Name/ Common Name	Minimum Size	Approximate Spacing	#	Required
VAN BUREN	RELOCATE 2 PALMS TO VAN BUREN	EXIST.	45'		2

- 6. Both a street tree Relocation/Removal permit as issued by the Park and Recreation Department and a Street Opening permit as issued by the Public Works Department are required prior to commencement of tree relocation and/or removal work, For all existing trees within what will ultimately be the Public Right-of Way pavement area, backfill of all holes must be inspected by the Public Works Inspector for proper compaction.
- 7. All Street Trees must be automatically irrigated, except where adjacent to single family or duplex residential uses.
- * NOTE: In the interest of public safety and maintenance the Street Tree Inspector shall have the authority to revise the street tree quantities and locations shown on approved plans based upon field conditions found at the time of installation of the trees.

- Department Standards and City of Riverside Street Tree policies.
- 2. When calling for inspections contact the Street Tree Inspector a minimum of 48 hours in advance at (909) 351-6126 to schedule an inspection. A Field Notice will be issued as written approval for each stage of inspetion. A
- verbal approval will not be acceptable. Inspections are required: a. After completion of final grading of the lots and when all utility
- c. After planting and all other indicated or specified work has been
- d. At end of the maintenance period, the contractor/developer shall call the Street Tree Inspector at (909)351-6126 for a final acceptance inspection in order to be released from maintenance. Developers bonds will not be the trees pass final inspection and the Park and Recreation Department is

- 5. Street tree planting shall be as follows:

Street Name	Botanical Name/ Common Name	Minimum Size	Approximate Spacing	# Required
VAN BUREN	RELOCATE 2 PALMS TO VAN BUREN	EXIST.	45'	2
CALIFORNIA	MAGNOLIA 'MAJESTIC BEAUTY'/ SOUTHERN MAGNOLIA	15 GAL.	45'	2

14. Quantities shown are for information only and the City of Riverside is not responsible for their accuracy. 16. In pavement overlay areas, distressed existing pavement shall be removed

GENERAL NOTES

1. It shall be the responsibility of the contractor to clear the right of way in accordance with the provisions of law as it affects each utility

2. Construction shall be in accordance with the City of Riverside Dept.

3. Where new pavement is to join the existing pavement, the edge of the

Specifications for Public Works Construction, Current Edition.

5. All flagged elevations shall be staked in the field by the private

6. The private engineer signing these plans is responsible for assuring the accuracy and acceptability of the work hereon. In the event of

discrepancies arising during construction, the private engineer shall be responsible for determining an acceptable solution and revising the

7. The developer shall be responsible for preserving or re—establishing and referencing survey monuments destroyed, disturbed or buried as

8. On all areas within public right of way where the fill is one (1) foot or greater, a letter will be required from the soils engineeer,

9. All traffic signs shall be installed prior to opening the streets to

10. Notice to contractor. The existence and location of any underground

are no existing utilities except as shown on these plans. The

utility pipes or structures shown on these plans were obtained by a

search of the available records. To the best of our knowledge there

contractor is required to take precautionary measures to protect the

11. Contractor agrees that he shall assume sole and complete responsibility for job site conditions during the course of construction of this

project, including safety of all persons and property; that this requirement shall apply continuously and not be limited to normal working hours; and that the contractor shall defend, indemnify and hold

12. Any traffic control striping obliterated and/or badly worn during construction shall be restored by the contractor within five days

been provided an inquiry identification number by U.S.A.

13. The contractor shall call in a location request to Underground Service

Alert (USA), Phone No. 1-800-227-2600, two working days before digging. No construction permit will be issued by the Public Works Department involving excavation for underground facilities unless the applicant has

utility lines shown and any other lines not of record or not shown on

the owner and the engineer harmless from any and all liability, real or

alleged, in connection with the performance of work on this project, excepting for liability arising from the sole negligence of the owner or

certifying the compaction of the fill below subgrade, prior to issuance

4. Construct driveway approaches per Std. Dwg. 302. and as approved by the Traffic Engineer.

plans for approval by the City.

a result of construction shown hereon.

of the Construction Permit/Cut Sheets.

including irrigation lines and appurtenances and at no cost to the City.


of Public Works, Standard Drawings, Its supplemental notes and the Standard

existing pavement shall be trimmed in a smooth and straight line. Construct match—up paving as shown on the plans and overlay paving as directed in the field to produce a smooth section.

- and replaced as directed by the inspector prior to overlaying with A.C.
- 17. Final striping for traffic control and/or pavement marking to be the responsibility of the developer.

after notification from the City Inspectors.

- 18. Coontact the Public Utilities Electric Department thirty (30) days prior to construction to allow the Department to prepare Électric Utility Relocation Plans for bidding and construction purposes. Contact Bill Armenta at (909) 782-5629
- 19. See Traffic Signal Plan X-331A for traffic signal facilities and stripina.
- 20. No person shall perform any construction activity or install any objects within the public rights—of way or easements of the City of Riverside without a valid Construction Permit or a Street Opening Permit or an Encroachment Permit issued by the City's Public Works Department.
- 21. PEVELOPER TO GIVE CITY WATER DIVISION FIVE (6) WORKING DAYS WRITTEN NOTICE PRIOR TO START OF CONSTRUCTION AND TO ALLOW CITY TEN (10) WORKING DAYS FOR COMPLETION DE WORK (909) 351 - 6368

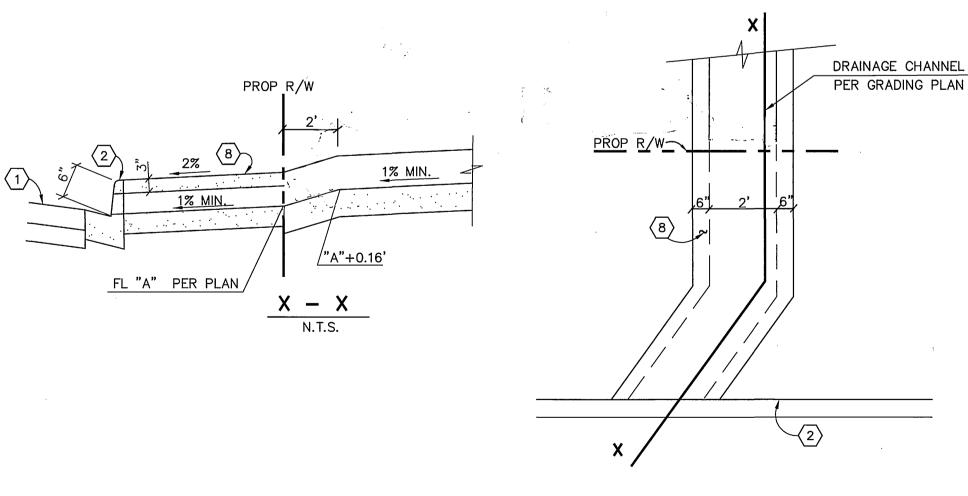

CURB OUTLET DETAIL MODIFIED CITY STD. 410 N.T.S.

APPROVED BY

PRINCIPAL ENGR.

PARK DEPARTMENT

DEP. P.W. DIRECTOR

TRAFFIC DIVISION

STREET SERVICES

DRAWN BY C.C. CHECKED BY D.J.E. ()

CITY OF RIVERSIDE, CALIFORNIA

DEPARTMENT OF PUBLIC WORKS

| BY |DATE | APPROVÉD BY

DIRECTOR OF PUBLIC WORKS

DATE Globe

AS BUILT CD 3/3/98

PROJECT NO. 1013-00

9485 CALIFORNIA AVE. RIVERSIDE, CA STREET IMPROVEMENT PLAN VAN BUREN STA. 20+61.60 TO 21+94.54

IN THE CITY OF RIVERSIDE

CU-011-967

FOR: JACK IN THE BOX #3366

R - 3472CALIFORNIA STA. 25+34.33 TO 27+24.48

FILE NO.: 9613457

INDEXED 7-10-97 4H

